

Date: Monday, 11/08/2008 10:06:36 AM  
 User: Linda Lacle

## Process Sheet

Customer : CU-DAR001 Dart Helicopters Services  
 Job Number : 41091  
 Estimate Number : 10262  
 P.O. Number :  
 This Issue : 11/08/2008 S.O. No. :  
 Prsht Rev. : NC  
 First Issue : 11/08/2008 Type : SKIDTUBES  
 Previous Run : 40697  
 Written By :  
 Checked & Approved By : JW 08.8.11  
 Comment : Est Rev: I 02.09.25 Rearranged procedure steps KJ  
 Est Rev: J 06-03-23 As per Rev D JLM  
 Est Rev: K 06-07-13 As per dsi9343 EC  
 Est Rev: L 07-07-28 Added SS Wearplates (Rev E) JLM  
 Verified By: EC  
 Est Rev: M 08-04-22 update steps 4, 13 DD verified by: EC

Drawing Name : 350 SKIDTUBE ASSEMBLY LH  
 Part Number : D350636011  
 Drawing Number : D2750 UNDER REVIEW  
 Project Number : N/A  
 Drawing Revision :  
 Material :  
 Due Date : 30/08/2008 Qty: 1 Um: Each

*Handwritten notes:* 08.08.12  
UPDATE PER  
DSI 9413

## Additional Product

Job Number:



Seq. #: Machine Or Operation: Description :

1.0 DC DOCUMENT CONTROL



JW 08.8.26



Comment: DOCUMENT CONTROL

Photocopy blue file and type labels per PPP D350-636-011 CHG 004 08.08.12

2.0 D26003BENT Extrusion Bent



Comment: Qty.: 1.0000 Each(s)/Unit Total : 1.0000 Each(s)

Pick:

Qty Part Number Description Batch  
 1 D2600-3-Bent Extrusion (Bent) 39714 SL 8-8-13

3.0 D2744 Cap



Comment: Qty.: 1.0000 Each(s)/Unit Total : 1.0000 Each(s)

Cap

Batch: 37164 SL 8-8-13

4.0 SKIDTUBES 1 SKIDTUBESS RESOURCE 1



Comment: LANDING GEAR RESOURCE 1

1- Mark cut line on aft end of D2600-3-Bent using Jig DT 8150. Cut to length as per Dwg D2750. Deburr end

2-Drill pilot holes as per Dwg D2750 sheet 3 (D2750-1 details). Drill using drill Jig DT8150 & DT8863.

SL 8-8-13

W/O:		WORK ORDER CHANGES						
DATE	STEP	PROCEDURE CHANGE		By	Date	Qty	Approval Chief Eng / Prod Mgr	Approval QC Inspector

Part No: \_\_\_\_\_ PAR #: \_\_\_\_\_ Fault Category: \_\_\_\_\_ NCR: Yes No DQA: \_\_\_\_\_ Date: \_\_\_\_\_

QA: N/C Closed: \_\_\_\_\_ Date: \_\_\_\_\_

NCR:		WORK ORDER NON-CONFORMANCE (NCR)							
DATE	STEP	Description of NC Section A	Corrective Action		Section B		Verification Section C	Approval Chief Eng	Approval QC Inspector
			Initial Chief Eng	Action Description Chief Eng		Sign & Date			

**NOTE:** Date & initial all entries

Date: Monday, 11/08/2008 10:06:36 AM  
User: Linda Lacelle

## Process Sheet

Customer: CU, DAR001 Dart Helicopters Services

Drawing Name: 350 SKIDTUBE ASSEMBLY LH

Job Number: 41091

Part Number: D350636011

Job Number:



Seq. #:

Machine Or Operation:

Description :

3- Mark fwd end for cutting using Drill Jig DT 8150 & DT8863 and cut as per dwg D2750.

4-Drill pilot holes for Detail G using DT8330

5-Open up holes for Detail B to 0.375" (4 holes per side) and blade fitting location holes to 0.500" (total of 5 holes per side) as per dwg D2750 .Open up holes for ground handling and detail E to 0.500" (8 holes per side)

6-Drill pilot holes for wearplates as per Dwg D2750 using DT8108

\*\*\*\*Make sure that wearplate holes are on bottom of tube\*\*\*\*\* Open 4 aft wearplate holes to 0.250". Open remaining wearplate holes to 0.297"

7-Open up holes of Detail A to 0.297" (total of 2 holes per side)

9-Weld D2744 Cap as per Dwg D2750 and QSI 004.Fill grooves in bend left from bending as per QSI 004  
A/R Aluminum Rod *in 107877/m108096 BE 8-8-14*

10-Grind welds flush as per Dwg D2750

12- Scribe batch# inside per dwg D2750

5.0

QC10

VISUAL INSPECTION OF GROUND WELDS



Comment: VISUAL INSPECTION OF GROUND WELDS

6.0

QC5

INSPECT WORK TO CURRENT STEP



Comment: INSPECT WORK TO CURRENT STEP

7.0

HAND FINISHING1

HAND FINISHING RESOURCE #1



Comment: HAND FINISHING RESOURCE #1

Chemical Conversion Coat as per QSI 005 4.1

8.0

QC3

INSPECT POWDER COAT/CHEMICAL CONVERSION



Comment: INSPECT POWDER COAT/CHEMICAL CONVERSION

*am 08-08-14*

W/O:		WORK ORDER CHANGES						
DATE	STEP	PROCEDURE CHANGE		By	Date	Qty	Approval Chief Eng / Prod Mgr	Approval QC Inspector

Part No: \_\_\_\_\_ PAR #: \_\_\_\_\_ Fault Category: \_\_\_\_\_ NCR: Yes No DQA: \_\_\_\_\_ Date: \_\_\_\_\_

QA: N/C Closed: \_\_\_\_\_ Date: \_\_\_\_\_

NCR:		WORK ORDER NON-CONFORMANCE (NCR)							
DATE	STEP	Description of NC Section A	Corrective Action		Section B		Verification Section C	Approval Chief Eng	Approval QC Inspector
			Initial Chief Eng	Action Description Chief Eng	Sign & Date				

**NOTE:** Date & initial all entries

Date: Monday, 11/08/2008 10:06:36 AM  
User: Linda Lacelle

## Process Sheet

Customer: -CU-DAR001 Dart Helicopters Services

Drawing Name: 350 SKIDTUBE ASSEMBLY LH

Job Number: 41091

Part Number: D350636011

Job Number:



Seq. #:

Machine Or Operation:

Description :

9.0

D2739

350 I Beam



Comment: Qty.: 1.0000 Each(s)/Unit Total : 1.0000 Each(s)

Web

Batch:

41127

SL 8-8-14

10.0

D34901

Cross Bolt Spacer



Comment: Qty.: 4.0000 Each(s)/Unit Total : 4.0000 Each(s)

Crossbolt spacer

Batch:

34564

SL 8-8-18

(4)

11.0

D34903

Cross Bolt Spacer



Comment: Qty.: 4.0000 Each(s)/Unit Total : 4.0000 Each(s)

Crossbolt spacer

Batch:

40727

SL 8-8-18

(4)

12.0

D2743

Crossbolt Spacer



Comment: Qty.: 8.0000 Each(s)/Unit Total : 8.0000 Each(s)

Crossbolt Spacer

Batch:

30755

SL 8-8-18

(8)

13.0

SKIDTUBES 1

SKIDTUBESS RESOURCE 1



Comment: LANDING GEAR RESOURCE 1

1-Open up holes of Detail E and ground handling to 0.625" (total of 8 holes per side) as per dwg D2750.

2-Open up holes of Detail B to 0.750" (total of 4 holes per side) as per dwg D2750.

3- Open float hole to 0.500" (4 per side)

4-Chamfer holes of Detail B, E, ground handling and float holes per dwg D2750 (welding instructions on sheet 4)

5-Deburr and blow out all chips from inside of tube

6- Prepare tube for welding, remove alodine as required.

SL 8-8-18

W/O:		WORK ORDER CHANGES						
DATE	STEP	PROCEDURE CHANGE		By	Date	Qty	Approval Chief Eng / Prod Mgr	Approval QC Inspector

Part No: \_\_\_\_\_ PAR #: \_\_\_\_\_ Fault Category: \_\_\_\_\_ NCR: Yes No DQA: \_\_\_\_\_ Date: \_\_\_\_\_

QA: N/C Closed: \_\_\_\_\_ Date: \_\_\_\_\_

NCR:		WORK ORDER NON-CONFORMANCE (NCR)						
DATE	STEP	Description of NC Section A	Corrective Action			Verification Section C	Approval Chief Eng	Approval QC Inspector
			Initial Chief Eng	Action Description Chief Eng	Sign & Date			

NOTE: Date & initial all entries

Date: Monday, 11/08/2008 10:06:36 AM  
User: Linda Lacelle

## Process Sheet

Customer: CU-DAR001 Dart Helicopters Services

Drawing Name: 350 SKIDTUBE ASSEMBLY LH

Job Number: 41091

Part Number: D350636011

Job Number:



Seq. #:

Machine Or Operation:

Description :

7-Bond web D2739 in place as per QSI 015

A/R Sikaflex-291

batch: 107893

exp. date: 8-10-1

SL 8-8-14

8- Weld spacers D3490-1, D3490-3 and D2743 as per dwg D2750 & QSI004

(welding instructions on sheet 4)

A/R Aluminum Rod

batch:

M108096

BE 8-8-19

9-Grind welds flush as per Dwg D2750

JD 8-8-19

10-Spot face ground handling holes section P-P (total of 4 places per side) as per dwg D2750

JD 8-8-20

11-Debur holes

14.0

QC10

VISUAL INSPECTION OF GROUND WELDS



Comment: VISUAL INSPECTION OF GROUND WELDS

8 08/08/20 (X)

15.0

QC5

INSPECT WORK TO CURRENT STEP



Comment: INSPECT WORK TO CURRENT STEP

8 08/08/20 (X)

16.0

HAND FINISHING1

HAND FINISHING RESOURCE #1



Comment: HAND FINISHING RESOURCE #1

Pressure wash as per QSI 005

FL 08/08/20 (P)

17.0

POWDER COATING

POWDER COATING



M108523



(X)

Comment: POWDER COATING

Powder Coat Gloss White (Ref. 4.3.5.1) as per Dart QSI 005 4.3

START TIME:

1:40

OVEN TEMPERATURE:

320

FINISH TIME:

2:10

M-1 08/08/20

18.0

QC3

INSPECT POWDER COAT/CHEMICAL CONVERSION



Comment: INSPECT POWDER COAT/CHEMICAL CONVERSION

Inspect for foreign object per QSI 024

08-08-22 (X)

W/O:		WORK ORDER CHANGES							
DATE	STEP	PROCEDURE CHANGE		By	Date	Qty	Approval Chief Eng / Prod Mgr	Approval QC Inspector	

Part No: \_\_\_\_\_ PAR #: \_\_\_\_\_ Fault Category: \_\_\_\_\_ NCR: Yes No DQA: \_\_\_\_\_ Date: \_\_\_\_\_

QA: N/C Closed: \_\_\_\_\_ Date: \_\_\_\_\_

NCR:		WORK ORDER NON-CONFORMANCE (NCR)							
DATE	STEP	Description of NC Section A	Corrective Action		Section B		Verification Section C	Approval Chief Eng	Approval QC Inspector
			Initial Chief Eng	Action Description Chief Eng	Sign & Date				

NOTE: Date & initial all entries



Date: Monday, 11/08/2008 10:06:36 AM  
User: Linda Lacelle

## Process Sheet

Customer: CU-DAR001 Dart Helicopters Services

Drawing Name: 350 SKIDTUBE ASSEMBLY LH

Job Number: 41091

Part Number: D350636011

Job Number:



Seq. #:

Machine Or Operation:

Description :

19.0

ALS41032225

Insert



Comment: Qty.: 42.0000 Each(s)/Unit Total : 42.0000 Each(s)

Insert

Batch: M100489

HL

20.0

HAND FINISHING1

HAND FINISHING RESOURCE #1



Comment: HAND FINISHING RESOURCE #1

Install inserts as per Dwg D2750

HL

08.08.22

(X1)

21.0

D2745

Bushing



Comment: Qty.: 8.0000 Each(s)/Unit Total : 8.0000 Each(s)

Bushing

Batch: B36230

HL

22.0

D37931

Wearshoe



Comment: Qty.: 1.0000 Each(s)/Unit Total : 1.0000 Each(s)

WEARSHOE

Batch: B40551

HL

23.0

D353525

Wearshoe



Comment: Qty.: 1.0000 Each(s)/Unit Total : 1.0000 Each(s)

WEARSHOE

Batch: B39716

HL

24.0

D37933

Wearshoe



Comment: Qty.: 1.0000 Each(s)/Unit Total : 1.0000 Each(s)

WEARSHOE

Batch: B40552

HL

25.0

D37941

Gasket



Comment: Qty.: 1.0000 Each(s)/Unit Total : 1.0000 Each(s)

GASKET

Batch: B40553

HL

08.08.22

RC

W/O:		WORK ORDER CHANGES							
DATE	STEP	PROCEDURE CHANGE		By	Date	Qty	Approval Chief Eng / Prod Mgr	Approval QC Inspector	

Part No: \_\_\_\_\_ PAR #: \_\_\_\_\_ Fault Category: \_\_\_\_\_ NCR: Yes No DQA: \_\_\_\_\_ Date: \_\_\_\_\_

QA: N/C Closed: \_\_\_\_\_ Date: \_\_\_\_\_

NCR:		WORK ORDER NON-CONFORMANCE (NCR)							
DATE	STEP	Description of NC Section A	Corrective Action		Section B		Verification Section C	Approval Chief Eng	Approval QC Inspector
			Initial Chief Eng	Action Description Chief Eng		Sign & Date			

NOTE: Date & initial all entries

Date: Monday, 11/08/2008 10:06:36 AM  
User: Linda Lacelle

## Process Sheet

Customer: CU-DAR001 Dart Helicopters Services

Drawing Name: 350 SKIDTUBE ASSEMBLY LH

Job Number: 41091

Part Number: D350636011

Job Number:



Seq. #:

Machine Or Operation:

Description :

26.0

D353625

Gasket



Comment: Qty.: 1.0000 Each(s)/Unit Total : 1.0000 Each(s)

GASKET

Batch: B40729

JH

27.0

D37943

Gasket



Comment: Qty.: 1.0000 Each(s)/Unit Total : 1.0000 Each(s)

GASKET

Batch: B39713

JH

28.0

D35371

Wearpad



Comment: Qty.: 3.0000 Each(s)/Unit Total : 3.0000 Each(s)

WEARPAD

Batch: B38941

3 per 08-08-12

JH

29.0

D36311

Washer



Comment: Qty.: 8.0000 Each(s)/Unit Total : 8.0000 Each(s)

WASHER

Batch: B392139

JH

30.0

D3488041

Blade Fitting Assembly, LH



Comment: Qty.: 1.0000 Each(s)/Unit Total : 1.0000 Each(s)

Blade Fitting, LH

Batch: B38786

JH

31.0

D3492041

Plug Assembly



Comment: Qty.: 8.0000 Each(s)/Unit Total : 8.0000 Each(s)

PLUG ASSEMBLY

Batch: B41058

JH

32.0

D3492043

Plug Assembly



Comment: Qty.: 8.0000 Each(s)/Unit Total : 8.0000 Each(s)

PLUG ASSEMBLY

Batch: B41090

JH

08-08-22 (K)

W/O:		WORK ORDER CHANGES							
DATE	STEP	PROCEDURE CHANGE		By	Date	Qty	Approval Chief Eng / Prod Mgr	Approval QC Inspector	

Part No: \_\_\_\_\_ PAR #: \_\_\_\_\_ Fault Category: \_\_\_\_\_ NCR: Yes No DQA: \_\_\_\_\_ Date: \_\_\_\_\_

QA: N/C Closed: \_\_\_\_\_ Date: \_\_\_\_\_

NCR:		WORK ORDER NON-CONFORMANCE (NCR)							
DATE	STEP	Description of NC Section A	Corrective Action		Section B		Verification Section C	Approval Chief Eng	Approval QC Inspector
			Initial Chief Eng	Action Description Chief Eng	Sign & Date				

NOTE: Date & initial all entries

Date: Monday, 11/08/2008 10:06:36 AM  
User: Linda Lacelle

## Process Sheet

Customer: CU-DAR001 Dart Helicopters Services

Drawing Name: 350 SKIDTUBE ASSEMBLY LH

Job Number: 41091

Part Number: D350636011

Job Number:



Seq. #:

Machine Or Operation:

Description :

33.0

AN3C5A

Bolt



34 PA 06.08.12

Comment: Qty.: ~~34~~ 28.0000 Each(s)/Unit Total: ~~34~~ 28.0000 Each(s)

Bolt

Batch: M108744

HL

34.0

AN3C6A

BOLT



Comment: Qty.: 4.0000 Each(s)/Unit Total: 4.0000 Each(s)

Bolt

Batch: M105300

HL

35.0

AN3C7A

BOLT



Comment: Qty.: 4.0000 Each(s)/Unit Total: 4.0000 Each(s)

BOLT

Batch:

PER PSI 9413

PA 06.08.12

36.0

AN6C44A

BOLT



Comment: Qty.: 4.0000 Each(s)/Unit Total: 4.0000 Each(s)

BOLT

Batch: M109091

HL

X

37.0

AN8C35A

BOLT



Comment: Qty.: 1.0000 Each(s)/Unit Total: 1.0000 Each(s)

BOLT

Batch: M106896

HL

38.0

AN960C10L

washer



38 PA 06.08.12

Comment: Qty.: ~~34~~ 28.0000 Each(s)/Unit Total: ~~34~~ 28.0000 Each(s)

washer

Batch: M108618

HL

39.0

AN960C816L

WASHER



1 PA 06.08.12

Comment: Qty.: ~~12~~ 2.0000 Each(s)/Unit Total: ~~12~~ 2.0000 Each(s)

WASHER

Batch: M107520

HL

08.08.22

CV

W/O:		WORK ORDER CHANGES							
DATE	STEP	PROCEDURE CHANGE		By	Date	Qty	Approval Chief Eng / Prod Mgr	Approval QC Inspector	

Part No: \_\_\_\_\_ PAR #: \_\_\_\_\_ Fault Category: \_\_\_\_\_ NCR: Yes No DQA: \_\_\_\_\_ Date: \_\_\_\_\_

QA: N/C Closed: \_\_\_\_\_ Date: \_\_\_\_\_

NCR:		WORK ORDER NON-CONFORMANCE (NCR)							
DATE	STEP	Description of NC Section A	Corrective Action		Section B		Verification Section C	Approval Chief Eng	Approval QC Inspector
			Initial Chief Eng	Action Description Chief Eng		Sign & Date			

**NOTE:** Date & initial all entries

Date: Monday, 11/08/2008 10:06:36 AM  
User: Linda Lacelle

## Process Sheet

Customer: CU-DAR001 Dart Helicopters Services

Drawing Name: 350 SKIDTUBE ASSEMBLY LH

Job Number: 41091

Part Number: D350636011

Job Number:



Seq. #:

Machine Or Operation:

Description :

40.0

MS210436

NUT



Comment: Qty.: 4.0000 Each(s)/Unit Total: 4.0000 Each(s)

NUT

Batch: M108744

JA

41.0

MS21083C8

NUT



Comment: Qty.: 1.0000 Each(s)/Unit Total: 1.0000 Each(s)

NUT

Batch: M1108880

JA

42.0

NAS1515H3L

WASHER



Comment: Qty.: 4.0000 Each(s)/Unit Total: 4.0000 Each(s)

WASHER

Batch: M107394

JA

43.0

NAS1515H8L

WASHER



Comment: Qty.: 2.0000 Each(s)/Unit Total: 2.0000 Each(s)

WASHER

Batch:

NOT REQ'D

PER 03.08.12

PER OSI 9413

44.0

D37911

Wearplate



Comment: Qty.: 1.0000 Each(s)/Unit Total: 1.0000 Each(s)

Wearplate

Batch: 1339694

JA

45.0

AN526C1032R10

Screw



Comment: Qty.: 4.0000 Each(s)/Unit Total: 4.0000 Each(s)

Screw

Batch: M1108062

JA

46.0

AN526C1032R18

Screw



Comment: Qty.: 4.0000 Each(s)/Unit Total: 4.0000 Each(s)

Screw

Batch: M1108079

JA

08.08.22

(X)

W/O:		WORK ORDER CHANGES							
DATE	STEP	PROCEDURE CHANGE		By	Date	Qty	Approval Chief Eng / Prod Mgr	Approval QC Inspector	

Part No: \_\_\_\_\_ PAR #: \_\_\_\_\_ Fault Category: \_\_\_\_\_ NCR: Yes No DQA: \_\_\_\_\_ Date: \_\_\_\_\_

QA: N/C Closed: \_\_\_\_\_ Date: \_\_\_\_\_

NCR:		WORK ORDER NON-CONFORMANCE (NCR)							
DATE	STEP	Description of NC Section A	Corrective Action		Section B		Verification Section C	Approval Chief Eng	Approval QC Inspector
			Initial Chief Eng	Action Description Chief Eng	Sign & Date				

NOTE: Date & initial all entries



Date: Monday, 11/08/2008 10:06:36 AM  
User: Linda Lacelle

## Process Sheet

Customer: CU-DAR001 Dart Helicopters Services

Drawing Name: 350 SKIDTUBE ASSEMBLY LH

Job Number: 41091

Part Number: D350636011

Job Number:



Seq. #:

Machine Or Operation:

Description :

47.0

D36721

Phenolic Washer



Comment: Qty.: 8.0000 Each(s)/Unit Total : 8.0000 Each(s)

Phenolic Washer

B39275

JA

48.0

HAND FINISHING1

HAND FINISHING RESOURCE #1



Comment: HAND FINISHING RESOURCE #1

✓ 1-Inspect for Foreign Objects

✓ 2-Spray inside of tube with "LPS-3" batch: M1107992

3-Install blade fitting D3488-041, wearshoes and ground handling hardware as per dwg D2750

✓ SIKA FLEX 241

BATCH: M1108801

EXP DATE: 08/10

✓ 4-Coat all exposed fasteners with "LPS Procyon" batch: M1104251

08.08.25 K1

49.0

QC5

INSPECT WORK TO CURRENT STEP



Comment: INSPECT WORK TO CURRENT STEP

5 08/08/27

50.0

PACKAGING 1

PACKAGING RESOURCE #1



Comment: PACKAGING RESOURCE #1

Pick Packing Kit

51.0

D2741

Blade, 350 Skidtube



Comment: Qty.: 1.0000 Each(s)/Unit Total : 1.0000 Each(s)

Blade

Batch: B340724

PO 8/8/05 (1)

52.0

AN8C21A

BOLT



Comment: Qty.: 2.0000 Each(s)/Unit Total : 2.0000 Each(s)

Bolt

Batch: M1107924

8/8/27

(H) SC

W/O:		WORK ORDER CHANGES						
DATE	STEP	PROCEDURE CHANGE		By	Date	Qty	Approval Chief Eng / Prod Mgr	Approval QC Inspector

Part No: \_\_\_\_\_ PAR #: \_\_\_\_\_ Fault Category: \_\_\_\_\_ NCR: Yes No DQA: \_\_\_\_\_ Date: \_\_\_\_\_

QA: N/C Closed: \_\_\_\_\_ Date: \_\_\_\_\_

NCR:		WORK ORDER NON-CONFORMANCE (NCR)							
DATE	STEP	Description of NC Section A	Corrective Action		Section B		Verification Section C	Approval Chief Eng	Approval QC Inspector
			Initial Chief Eng	Action Description Chief Eng		Sign & Date			

**NOTE:** Date & initial all entries

Date: Monday, 11/08/2008 10:06:36 AM  
User: Linda Lacelle

## Process Sheet

Customer: CU-DAR001 Dart Helicopters Services

Drawing Name: 350 SKIDTUBE ASSEMBLY LH

Job Number: 41091

Part Number: D350636011

Job Number:



Seq. #:

Machine Or Operation:

Description :

53.0

AN960C816L

WASHER



2 4 14 08.08.12

Comment: Qty.: 2.0000 Each(s)/Unit Total: 2.0000 Each(s)

Washer

Batch: M107520

SP

54.0

NAS1515H8L

WASHER



Comment: Qty.: 2.0000 Each(s)/Unit Total: 2.0000 Each(s)

WASHER

Batch: M107581

SP

55.0

MS21083C8

NUT



Comment: Qty.: 2.0000 Each(s)/Unit Total: 2.0000 Each(s)

Nut

Batch: M107924

105880

SP

56.0

D34931

Washer



Comment: Qty.: 2.0000 Each(s)/Unit Total: 2.0000 Each(s)

WASHER

Batch: B39985

B40829

SP

57.0

D35321

Spacer



Comment: Qty.: 2.0000 (s)/Unit Total: 2.0000 (s)

batch: B38594

8/8/29

(2)

SP

58.0

QC4

INSPECT 100% KITS FOR COMPLETENESS



Comment: INSPECT 100% KITS FOR COMPLETENESS

8/9/16

59.0

PACKAGING 1

PACKAGING RESOURCE #1



Comment: PACKAGING RESOURCE #1

Package as per PPP D350-636-011

CHG 004 08.08.12

8/9/16

(1x)

SP

1341091

W/O:		WORK ORDER CHANGES						
DATE	STEP	PROCEDURE CHANGE		By	Date	Qty	Approval Chief Eng / Prod Mgr	Approval QC Inspector

Part No: \_\_\_\_\_ PAR #: \_\_\_\_\_ Fault Category: \_\_\_\_\_ NCR: Yes No DQA: \_\_\_\_\_ Date: \_\_\_\_\_

QA: N/C Closed: \_\_\_\_\_ Date: \_\_\_\_\_

NCR:		WORK ORDER NON-CONFORMANCE (NCR)							
DATE	STEP	Description of NC Section A	Corrective Action		Section B		Verification Section C	Approval Chief Eng	Approval QC Inspector
			Initial Chief Eng	Action Description Chief Eng	Sign & Date				

NOTE: Date & initial all entries

Date: Monday, 11/08/2008 10:06:36 AM  
User: Linda Lacelle

## Process Sheet

Customer: CU-DAR001 Dart Helicopters Services

Drawing Name: 350 SKIDTUBE ASSEMBLY LH

Job Number: 41091

Part Number: D350636011

Job Number:



Seq. #:

Machine Or Operation:

Description :

60.0

QC21

FINAL INSPECTION/W/O RELEASE



08/09/16 JH

Comment: FINAL INSPECTION/W/O RELEASE

Job Completion



mf 08-09-16

W/O:		WORK ORDER CHANGES							
DATE	STEP	PROCEDURE CHANGE		By	Date	Qty	Approval Chief Eng / Prod Mgr	Approval QC Inspector	

Part No: \_\_\_\_\_ PAR #: \_\_\_\_\_ Fault Category: \_\_\_\_\_ NCR: Yes No DQA: \_\_\_\_\_ Date: \_\_\_\_\_

QA: N/C Closed: \_\_\_\_\_ Date: \_\_\_\_\_

NCR:		WORK ORDER NON-CONFORMANCE (NCR)							
DATE	STEP	Description of NC Section A	Corrective Action		Section B		Verification Section C	Approval Chief Eng	Approval QC Inspector
			Initial Chief Eng	Action Description Chief Eng		Sign & Date			

**NOTE:** Date & initial all entries





DESIGN <i>PH</i>	DRAWN BY <i>CB</i>	<b>DART AEROSPACE USA, INC.</b> PORT HADLOCK, WA	
CHECKED <i>PH</i>	APPROVED <i>[Signature]</i>	DRAWING NO. <b>D2750</b>	REV. E SHEET 2 OF 5
DATE <b>07.05.17</b>		TITLE <b>350 SKIDTUBE ASSEMBLY</b> SCALE NTS	

GENERAL NOTES:

**RELEASED**  
*07-08-02 [Signature]*

1. ALL DIMENSIONS ARE IN INCHES.
2. TOLERANCES ARE PER DART QSI 018 UNLESS OTHERWISE NOTED.
3. MAKE FROM D2600-3 EXTRUSION (INITIAL LENGTH = 120.0).
4. DAMAGE TOLERANCE ON BENDING:  
THERE SHOULD BE NO VISIBLE WRINKLES IN THE BEND FROM THE GROUND TO A HEIGHT OF 12 INCHES ABOVE THE GROUND. NO GOUGING IS ACCEPTABLE IN THE FLAT PORTION OF THE TUBE. GOUGES UP TO 0.020 ARE ACCEPTABLE IN THE BENT PORTION OF THE TUBE. TUBE O.D. SHOULD BE  $3.150 \pm 0.010$  IN THE FLAT PORTION OF THE TUBE. TUBE O.D. SHOULD BE  $3.15 \pm 0.030$  IN THE BENT PORTION OF THE TUBE.
5. ALL HOLES DRILLED ON CENTERLINES EXCEPT THOSE NOTED BY SECTIONS C-C, D-D AND F-F.
6. WELDING TO BE DONE PER DART QSI 004.
7. FINAL CONFIGURATION SHOULD HAVE THE FOLLOWING MINIMUM MECHANICAL PROPERTIES:  
MINIMUM YIELD TENSILE STRENGTH = 35 ksi  
MINIMUM ULTIMATE TENSILE STRENGTH = 38 ksi
8. FINISH:  
ACID ETCH, ALODINE ASSEMBLY PER DART QSI 005 4.1 PRIOR TO INSTALLING D2739 WEB.  
POWDER COAT WHITE (REF. 4.3.5.1) PER DART QSI 005 4.3  
BLACK ANTI-SKID PAINT AS INDICATED TO 1.0 ABOVE SKIDTUBE CENTER-LINE PER DART 005 4.4 (OPTIONAL).
9. INSTALL ALS4-1032-225 INSERTS AFTER FINISH AS INDICATED IN D2750-1/-2/-3/-4 WELDING DETAIL ON PAGE 4 AND 5. DRILL 'F' SIZE HOLES ( $\emptyset 0.297$ ) FOR WEARSHOE INSERTS.
10. D3488-041 (OR D3488-042) BLADE FITTING AND AN3C5A/AN3C7A WEARSHOE BOLTS TO BE INSTALLED USING SIKAFLEX-241 (OR EQUIVALENT) SEALANT.
11. SPRAY INSIDE OF TUBE WITH A COAT OF LPS LABORATORIES "LPS-3" AFTER FINISH AND AFTER INSTALLATION OF INSERTS. COAT ALL EXPOSED FASTENERS WITH LPS LABORATORIES "LPS PROCYON" AFTER FINAL ASSEMBLY, CLEAN EXCESS OFF POWDER COATING WITH MEK DEGREASER.

SHOP COPY

RETURN TO

ENGINEERING

UNCONTROLLED COPY

SUBJECT TO AMENDMENT

WITHOUT NOTICE

WORK ORDER


NO. *41091*

**UNDER REVIEW**  
*PH 03-03-12*  
*03.05.17 [Signature]*  
UPDATE  
PER  
QSI 9419


**COPYRIGHT © 1998 BY DART AEROSPACE USA, INC.**

THIS DOCUMENT IS PRIVATE AND CONFIDENTIAL AND IS SUPPLIED ON THE EXPRESS CONDITION THAT IT IS NOT TO BE USED FOR ANY PURPOSE OR COPIED OR COMMUNICATED TO ANY OTHER PERSON WITHOUT WRITTEN PERMISSION FROM DART AEROSPACE USA, INC.






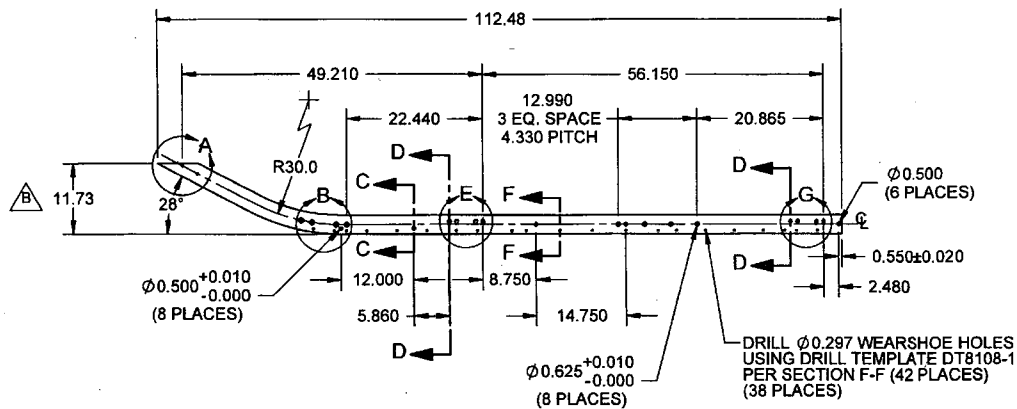


**D2750-1 LH SKIDTUBE (SHOWN)**  
**D2750-2 RH SKIDTUBE (OPPOSITE)**

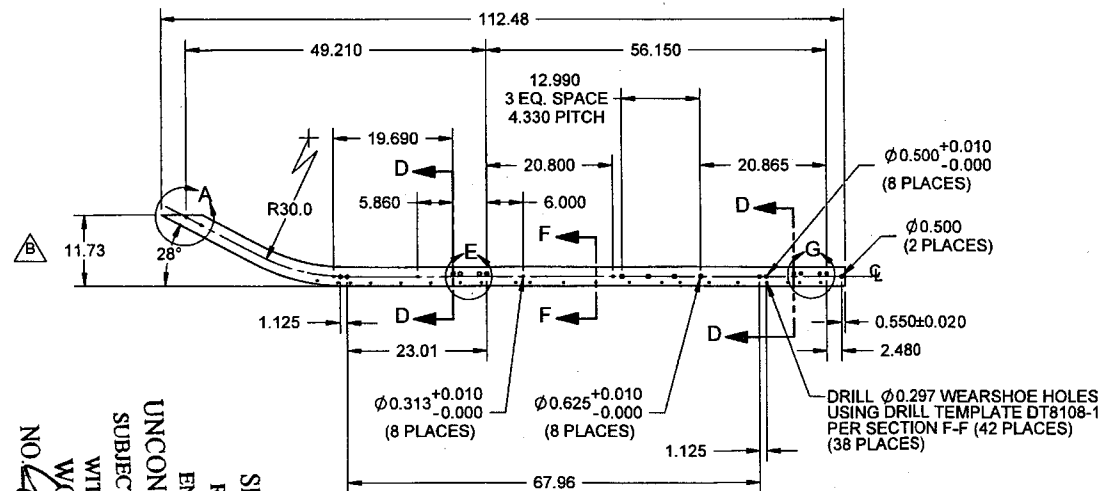


**D2750-3 LH SKIDTUBE (SHOWN)**  
**D2750-4 RH SKIDTUBE (OPPOSITE)**

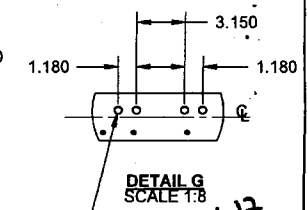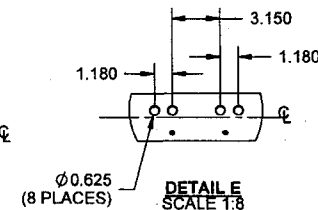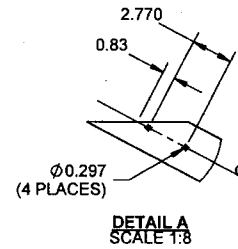


**UNDER REVIEW**  
07-05-12  
04.06.27  
UPDATE  
PER  
051 9419

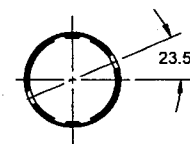

**SECTION C-C**  
**SCALE 1:4**

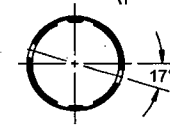


**SECTION D-D**  
**SCALE 1:4**

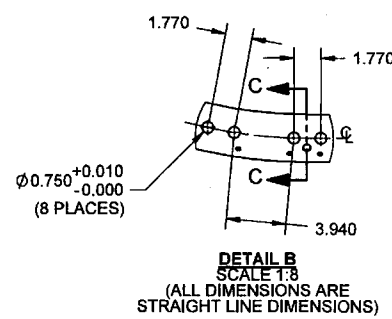

**DETAIL B**  
**SCALE 1:8**  
**(ALL DIMENSIONS ARE STRAIGHT LINE DIMENSIONS)**

**RELEASED**  
07-05-12

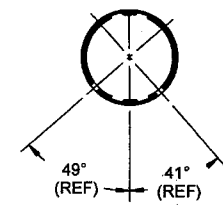

**SECTION F-F**  
**SCALE 1:4**

SHOP COPY  
RETURN TO  
ENGINEERING  
UNCONTROLLED COPY  
SUBJECT TO AMENDMENT  
WITHOUT NOTICE  
WORK ORDER  
NO. 44091

DESIGN	PH	DRAWN BY	CB	DART AEROSPACE USA, INC.	
CHECKED	PH	APPROVED	[Signature]	PORT HADLOCK, WA	
DATE	07.05.17	DRAWING NO.	D2750	REV. E	SHEET 3 OF 5
TITLE			350 SKIDTUBE ASSEMBLY		
SCALE			1:20		
COPYRIGHT © 1998 BY DART AEROSPACE USA, INC. THIS DOCUMENT IS PRIVATE AND CONFIDENTIAL AND IS SUPPLIED ON THE EXPRESS CONDITION THAT IT IS NOT TO BE USED FOR ANY PURPOSE OR COPIED OR COMMUNICATED TO ANY OTHER PERSON WITHOUT WRITTEN PERMISSION FROM DART AEROSPACE USA, INC.					

INSTALL ALS4-1032-225  
INSERTS (4 PLACES)  
AFTER FINISH

D2750-1 (LH) OR  
D2750-2 (RH)

INSTALL ALS4-1032-225  
WEARSHOE INSERTS (38 PLACES)  
AFTER FINISH

**D2750-041 ASSEMBLY (SHOWN)  
D2750-042 ASSEMBLY (OPPOSITE)**

BLACK ANTI-SKID

BOND D2739 WEB INTO D2750-1 (OR D2750-2)  
OUTER TUBE WITH NON-STRUCTURAL  
SIKAFLEX-241 ADHESIVE PER DART QSI 015.  
NOTE: ENSURE THAT HOLES LINE UP.

2.0  
(TYP)

1.78 (REF)  
(TO D2739 WEB)

D3488-041  
(OR D3488-042)

NO INSERT

WELDED SPACER  
NOT REQUIRED

AN3C7A BOLT (REF)

**RELEASED**  
07.05.17

UPDATE PER  
DSI 9413  
06.08.12

INSTALL:  
AN3C6A BOLT (1)  
AN960C10L WASHER (1)  
NAS1515H3L WASHER (1)  
(4 PLACES)

**SECTION J-J**  
SCALE 1:5

INSTALL AT AFTMOST  
D3537-1 WEARPAD:  
AN3C7A BOLTS (1)  
AN960C10L WASHER (1)  
(4 PLACES)

INSTALL:  
AN3C5A BOLT (1)  
AN960C10L WASHER (1)  
(38 PLACES)

**SECTION N-N**  
SCALE 1:5

D2743 SPACER (REF)

**SECTION M-M**  
SCALE 1:5

**WELDING INSTRUCTIONS**  
1) CHAMFER HOLE 0.050 x 45°  
2) INSERT D2743 SPACER  
3) WELD INTO PLACE  
4) GRIND WELD FLUSH  
5) DRILL OUT SPACER TO Ø0.484  
6) SPOT FACE Ø0.750 (SECTION P-P ONLY)

INSTALL:  
AN8C44A BOLT (1)  
D2745 BUSHING (2)  
D3631-1 WASHER (2)  
MS21043-6 NUT (1)  
(4 PLACES)

**SECTION Q-Q**  
SCALE 1:5

INSTALL:  
AN8C35A BOLT (1)  
AN960C816L WASHER (2)  
NAS1515H8L WASHER (2)  
MS21083C8 NUT (1)

**SECTION R-R**  
SCALE 1:5

**UNDER REVIEW**  
06.06.17  
UPDATE  
PER  
DSI 9413

D3490-3 SPACER

INSTALL:  
D3492-043 PLUG  
ASSEMBLY  
(2 PLACES)

**SECTION K-K**  
(FOR Ø0.750 HOLES ONLY)  
SCALE 1:5

**WELDING INSTRUCTIONS**  
1) CHAMFER HOLE 0.050 x 45°  
2) INSERT D3490-1 SPACER (4 PLACES) INTO  
Ø0.500 HOLES OR INSERT D3490-3 SPACER  
(4 PLACES) INTO Ø0.750 HOLES  
3) WELD INTO PLACE  
4) GRIND WELD FLUSH  
5) INSERT D3492-041 PLUG ASSEMBLY (8 PLACES)  
INTO D3490-1 SPACER OR INSERT D3492-043  
PLUG ASSEMBLY (8 PLACES) INTO D3490-3 SPACER  
ON BOTH ENDS AFTER FINISH

D3490-1 SPACER


INSTALL:  
D3492-041 PLUG  
ASSEMBLY  
(2 PLACES)

**SECTION L-L**  
(FOR Ø0.500 HOLES ONLY)  
SCALE 1:5

NO. 41091  
WORK ORDER  
SUBJECT TO AMENDMENT  
UNCONTROLLED COPY  
RETURN TO  
ENGINEERING  
SHOP COPY  
RETURN TO  
ENGINEERING

DESIGN PH	DRAWN BY CB	DART AEROSPACE USA, INC. PORT HADLOCK, WA	
CHECKED PH	APPROVED [Signature]	DRAWING NO. D2750	REV. E SHEET 4 OF 5
DATE 07.05.17		TITLE 350 SKIDTUBE ASSEMBLY	SCALE 1:10
COPYRIGHT © 1988 BY DART AEROSPACE USA, INC. THIS DOCUMENT IS PRIVATE AND CONFIDENTIAL AND IS SUPPLIED ON THE EXPRESS CONDITION THAT IT IS NOT TO BE USED FOR ANY PURPOSE OR COPIED OR COMMUNICATED TO ANY OTHER PERSON WITHOUT WRITTEN PERMISSION FROM DART AEROSPACE USA, INC.			

8 7 6 5 4 3 2 1

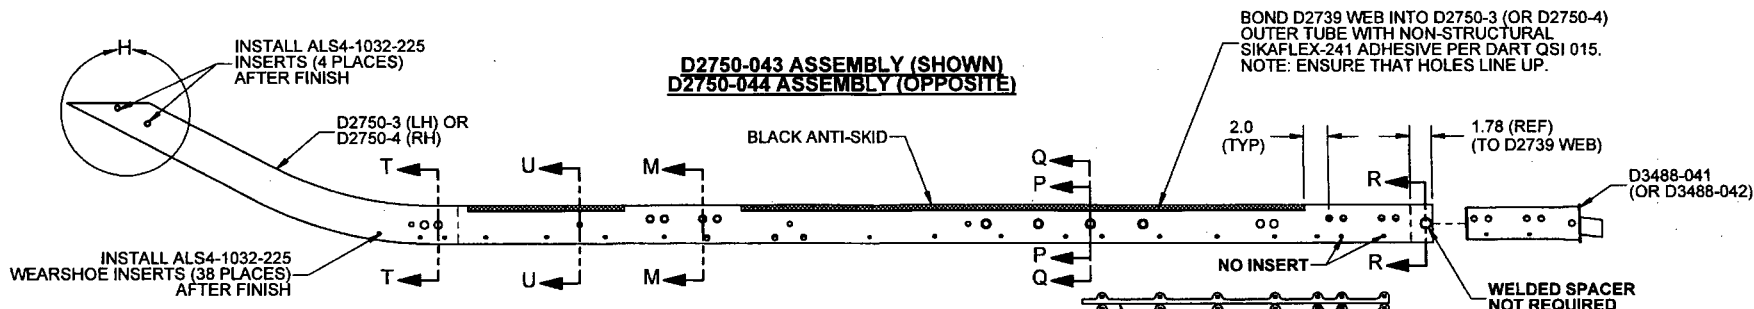

**D2750-043 ASSEMBLY (SHOWN)  
D2750-044 ASSEMBLY (OPPOSITE)**

**UNDER REVIEW**  
01.06.03  
UPDATE PER DSI 9419

INSTALL:  
AN3C6A BOLT (1)  
AN960C10L WASHER (1)  
NAS1515H3L WASHER (1)  
(4 PLACES)

**SECTION J-J  
SCALE 1:5**

INSTALL AT AFTMOST  
D3537-1 WEARPAD:  
AN3C7A BOLTS (1)  
AN960C10L WASHER (1)  
(4 PLACES)

**SECTION N-N  
SCALE 1:5**

INSTALL:  
AN3C5A BOLT (1)  
AN960C10L WASHER (1)  
(38 PLACES)

- WELDING INSTRUCTIONS**
- 1) CHAMFER HOLE 0.050 x 45°
  - 2) INSERT D2743 SPACER
  - 3) WELD INTO PLACE
  - 4) GRIND WELD FLUSH
  - 5) DRILL OUT SPACER TO Ø0.484
  - 6) SPOT FACE Ø0.750 (SECTION P-P ONLY)

**SECTION M-M  
SCALE 1:5**

**SECTION P-P  
SCALE 1:5**

**SECTION Q-Q  
SCALE 1:5**

INSTALL:  
AN6C44A BOLT (1)  
D2745 BUSHING (2)  
D3631-1 WASHER (2)  
MS21043-6 NUT (1)  
(4 PLACES)

INSTALL:  
AN8C35A BOLT (1)  
AN960C816L WASHER (2)  
NAS1515H8L WASHER (2)  
MS21083C8 NUT (1)


**SECTION R-R  
SCALE 1:5**

**DETAIL H  
SCALE 1:5**

**SECTION T-T  
(FOR Ø0.500 HOLES ONLY)  
SCALE 1:5**

- WELDING INSTRUCTIONS**
- 1) CHAMFER HOLE 0.050 x 45°
  - 2) INSERT D3490-5 SPACER (4 PLACES) INTO Ø0.313 HOLES OR INSERT D3490-1 SPACER (4 PLACES) INTO Ø0.500 HOLES
  - 3) WELD INTO PLACE
  - 4) GRIND WELD FLUSH
  - 5) INSERT D3492-045 PLUG ASSEMBLY (8 PLACES) INTO D3490-5 SPACER OR INSERT D3492-043 PLUG ASSEMBLY (8 PLACES) INTO D3490-1 SPACER ON BOTH ENDS AFTER FINISH

**SECTION U-U  
(FOR Ø0.313 HOLES ONLY)  
SCALE 1:5**

DESIGN PH	DRAWN BY CB	DART AEROSPACE USA, INC. PORT HADLOCK, WA		
CHECKED PH	APPROVED 	DRAWING NO. D2750	REV. E SHEET 5 OF 5	
DATE 07.05.17	TITLE 350 SKIDTUBE ASSEMBLY		SCALE 1:10	
COPYRIGHT © 1988 BY DART AEROSPACE USA, INC. THIS DOCUMENT IS PRIVATE AND CONFIDENTIAL AND IS SUPPLIED ON THE EXPRESS CONDITION THAT IT IS NOT TO BE USED FOR ANY PURPOSE OR COPIED OR COMMUNICATED TO ANY OTHER PERSON WITHOUT WRITTEN PERMISSION FROM DART AEROSPACE USA, INC.				

**UNDER REVIEW**  
01.06.03  
UPDATE PER DSI 9419

INSTALL:  
D3492-045 PLUG  
ASSEMBLY (2 PLACES)  
D3492-043 PLUG  
ASSEMBLY (2 PLACES)  
D3492-045 PLUG  
ASSEMBLY (2 PLACES)  
D3492-043 PLUG  
ASSEMBLY (2 PLACES)

**UNCONTROLLED COPY**  
RETURN TO  
ENGINEERING  
DEPT TO AMENDMENT  
WITHOUT NOTICE  
WORK ORDER

# DART SERVICE INSTRUCTION


TO AMEND INSTALLATION INSTRUCTIONS IIN-D350-636 REV E

REF FAA STC: SR00646SE


REF CANADIAN STC: SH99-7

THE WEARPLATES ON D350-636-011/-012/-013/-014 SKIDTUBES AT CHG 004 (AND LATER) HAVE BEEN MODIFIED AS SHOWN IN FIGURE 1 BELOW TO ELIMINATE THE POSSIBILITY OF INTERFERENCE BETWEEN THE WEARPLATES AND CROSSTUBE SADDLES AT INSTALLATION. THERE IS NEGLIGIBLE WEIGHT CHANGE ASSOCIATED WITH THIS MODIFICATION.

**WAS**

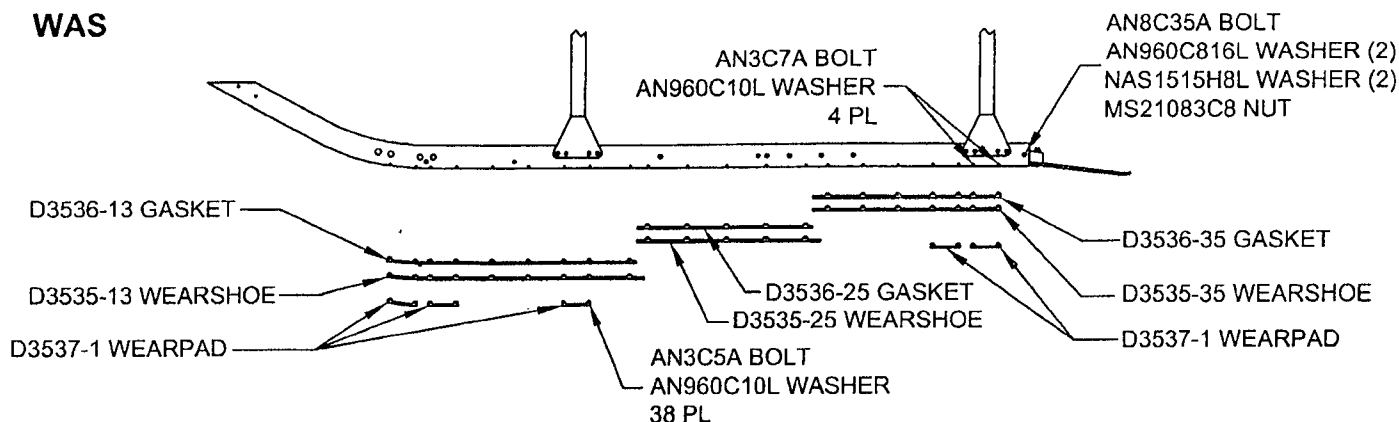

**NOW**

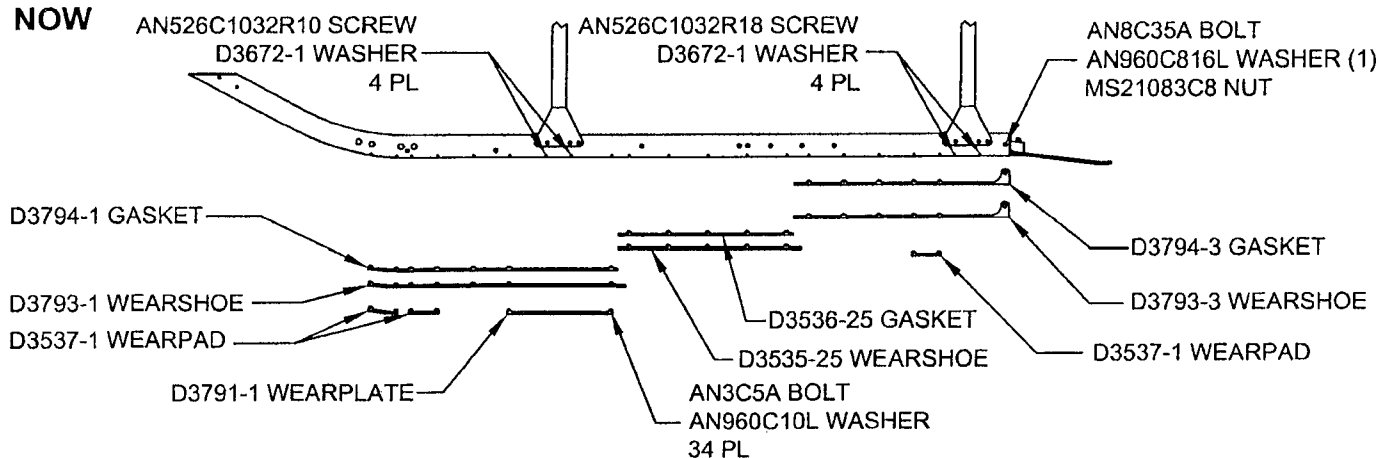

**FIGURE 1 - WEARPLATE MODIFICATION**

(AN526C1032RXX SCREW LOCATIONS NO LONGER USED TO MOUNT WEARSHOES)

SHOP COPY  
RETURN TO  
ENGINEERING  
UNCONTROLLED COPY  
SUBJECT TO AMENDMENT  
WITHOUT NOTICE  
WORK ORDER  
NO. 41091

A	NEW ISSUE	PH	08.05.14
REV.	DESCRIPTION	BY	DATE
DESIGN	PH	<b>DART AEROSPACE USA, INC</b> PORT HADLOCK, WA	
DRAWN	PH		
CHECKED		DRAWING NO.	REV. A
MFG. APPR.	N/A	DSI 9413	SHEET 1 OF 3
APPROVED		TITLE	SCALE
DE APPR.		WEARSHOE MODIFICATION	NTS
DATE	08.05.14	COPYRIGHT © 2008 BY DART AEROSPACE USA, INC <small>THIS DOCUMENT IS PRIVATE AND CONFIDENTIAL AND IS SUPPLIED ON THE EXPRESS CONDITION THAT IT IS NOT TO BE USED FOR ANY PURPOSE OR COPIED OR COMMUNICATED TO ANY OTHER PERSON WITHOUT WRITTEN PERMISSION FROM DART AEROSPACE USA, INC.</small>	

FOR D350-636-011/-012/-013/-014 SKIDTUBES AT CHG 004, AMEND PARTS LIST OF IIN-D350-636 SECTION 5 AS FOLLOWS:

REMOVE:

Item	Qty -011	Qty -012	Qty -013	Qty -014	Part Number	Description
	X				D350-636-011	SKIDTUBE INSTALLATION, LH, STD AERAZUR/APICAL CYLINDRICAL FLOAT COMPATIBLE
		X			D350-636-012	SKIDTUBE INSTALLATION, RH, STD AERAZUR/APICAL CYLINDRICAL FLOAT COMPATIBLE
			X		D350-636-013	SKIDTUBE INSTALLATION, LH AIRCRUISER/ APICAL TRI-BAG FLOAT COMPATIBLE
				X	D350-636-014	SKIDTUBE INSTALLATION, RH AIRCRUISER/ APICAL TRI-BAG FLOAT COMPATIBLE
*6A	1	1	1	1	AN960C816L	WASHER
6B	2	2	2	2	NAS1515H8L	WASHER
*22	2	2	2	2	D3537-1	WEARPAD
23A	1	1	1	1	D3535-13	WEARSHOE
23B	1	1	1	1	D3536-13	GASKET
25A	1	1	1	1	D3535-35	WEARSHOE
25B	1	1	1	1	D3536-35	GASKET
*26A	4	4	4	4	AN3C5A	BOLT
*26B	4	4	4	4	AN3C7A	BOLT
*27	8	8	8	8	AN960C10L	WASHER

\*SUBTRACT FROM TOTAL QUANTITY OF PARTS INDICATED IN INSTALLATION INSTRUCTIONS IIN-D350-636

ADD:

Qty -011	Qty -012	Qty -013	Qty -014	Part Number	Description
X				D350-636-011	SKIDTUBE INSTALLATION, LH, STD AERAZUR/APICAL CYLINDRICAL FLOAT COMPATIBLE
	X			D350-636-012	SKIDTUBE INSTALLATION, RH, STD AERAZUR/APICAL CYLINDRICAL FLOAT COMPATIBLE
		X		D350-636-013	SKIDTUBE INSTALLATION, LH AIRCRUISER/ APICAL TRI-BAG FLOAT COMPATIBLE
			X	D350-636-014	SKIDTUBE INSTALLATION, RH AIRCRUISER/ APICAL TRI-BAG FLOAT COMPATIBLE
1	1	1	1	D3791-1	WEARPLATE
1	1	1	1	D3793-1	WEARSHOE
1	1	1	1	D3793-3	WEARSHOE
1	1	1	1	D3794-1	GASKET
1	1	1	1	D3794-3	GASKET
8	8	8	8	D3672-1	WASHER
4	4	4	4	AN526C1032R10	SCREW
4	4	4	4	AN526C1032R18	SCREW

SHOP COPY  
RETURN TO  
ENGINEERING  
UNCONTROLLED COPY  
SUBJECT TO AMENDMENT  
WITHOUT NOTICE  
WORK ORDER  
NO. 41091

DESIGN	<i>PH</i>	<b>DART AEROSPACE USA, INC</b> PORT HADLOCK, WA	
DRAWN	<i>PH</i>		
CHECKED	<i>B</i>	DRAWING NO.	REV. A
MFG. APPR.	N/A	DSI 9413	SHEET 2 OF 3
APPROVED	<i>[Signature]</i>	TITLE	SCALE
DE APPR.	<i>[Signature]</i>	WEARSHOE MODIFICATION	NTS
DATE	08.05.14	COPYRIGHT © 2008 BY DART AEROSPACE USA, INC <small>THIS DOCUMENT IS PRIVATE AND CONFIDENTIAL AND IS SUPPLIED ON THE EXPRESS CONDITION THAT IT IS NOT TO BE USED FOR ANY PURPOSE OR COPIED OR COMMUNICATED TO ANY OTHER PERSON WITHOUT WRITTEN PERMISSION FROM DART AEROSPACE USA, INC.</small>	

TO IMPROVE THE INSTALLATION OF D350-636-011/-012/-013/-014 SKIDTUBES EQUIPPED WITH STAINLESS WEARPLATES/WEARPADS AND GASKETS (CHG 003) ONTO THE CROSSTUBES, THE FOLLOWING DSI 9413-011 WEARSHOE KIT CAN BE PROCURED FROM DART:

Qty -011	Part Number	Description
X	DSI 9413-011	WEARSHOE MODIFICATION KIT
1	D3791-1	WEARPLATE
1	D3793-1	WEARSHOE
1	D3793-3	WEARSHOE
1	D3794-1	GASKET
1	D3794-3	GASKET
8	D3672-1	WASHER
4	AN526C1032R10	SCREW
4	AN526C1032R18	SCREW


TO INSTALL THE DSI 9413-011 KIT, REMOVE THE EXISTING WEARSHOES/GASKETS UNDER THE FWD/AFT SADDLES AND INSTALL NEW WEARSHOES/GASKETS AS SHOWN IN FIGURE 1. PLUG UNUSED HOLES WITH AN526C1032RXX SCREWS AND D3672-1 WASHERS. INSTALL SCREWS WITH SIKAFLEX -241/-291 OR PROSEAL 890 OR MIL-S-8802 CLASS 'B2' SEALANT AS SHOWN IN FIGURE 1. **NOTE:** SOME OF THE PREVIOUSLY INSTALLED HARDWARE IS NO LONGER REQUIRED.

THE FOLLOWING D350-636-045 REPLACEMENT WEARPLATE KIT WILL BE AVAILABLE FOR D350-636-011/-012/-013/-014 SKIDTUBES AT CHG 004 OR LATER:

Qty -011	Part Number	Description
X	D350-636-045	WEARSHOE KIT
3	D3537-1	WEARPAD
1	D3535-25	WEARSHOE
1	D3536-25	GASKET
1	D3791-1	WEARPLATE
1	D3793-1	WEARSHOE
1	D3793-3	WEARSHOE
1	D3794-1	GASKET
1	D3794-3	GASKET
34	AN3C5A	BOLT
34	AN960C10L	WASHER

SHOP COPY  
RETURN TO  
ENGINEERING  
UNCONTROLLED COPY  
SUBJECT TO AMENDMENT  
WITHOUT NOTICE  
WORK ORDER  
NO. 41091

DESIGN	PH	<b>DART AEROSPACE USA, INC</b>	
DRAWN	PH	PORT HADLOCK, WA	
CHECKED	B	DRAWING NO.	REV. A
MFG. APPR.	N/A	DSI 9413	SHEET 3 OF 3
APPROVED	PH	TITLE	SCALE
DE APPR.	PH	WEARSHOE MODIFICATION	NTS
DATE	08.05.14	<small>COPYRIGHT © 2008 BY DART AEROSPACE USA, INC THIS DOCUMENT IS PRIVATE AND CONFIDENTIAL AND IS SUPPLIED ON THE EXPRESS CONDITION THAT IT IS NOT TO BE USED FOR ANY PURPOSE OR COPIED OR COMMUNICATED TO ANY OTHER PERSON WITHOUT WRITTEN PERMISSION FROM DART AEROSPACE USA, INC.</small>	

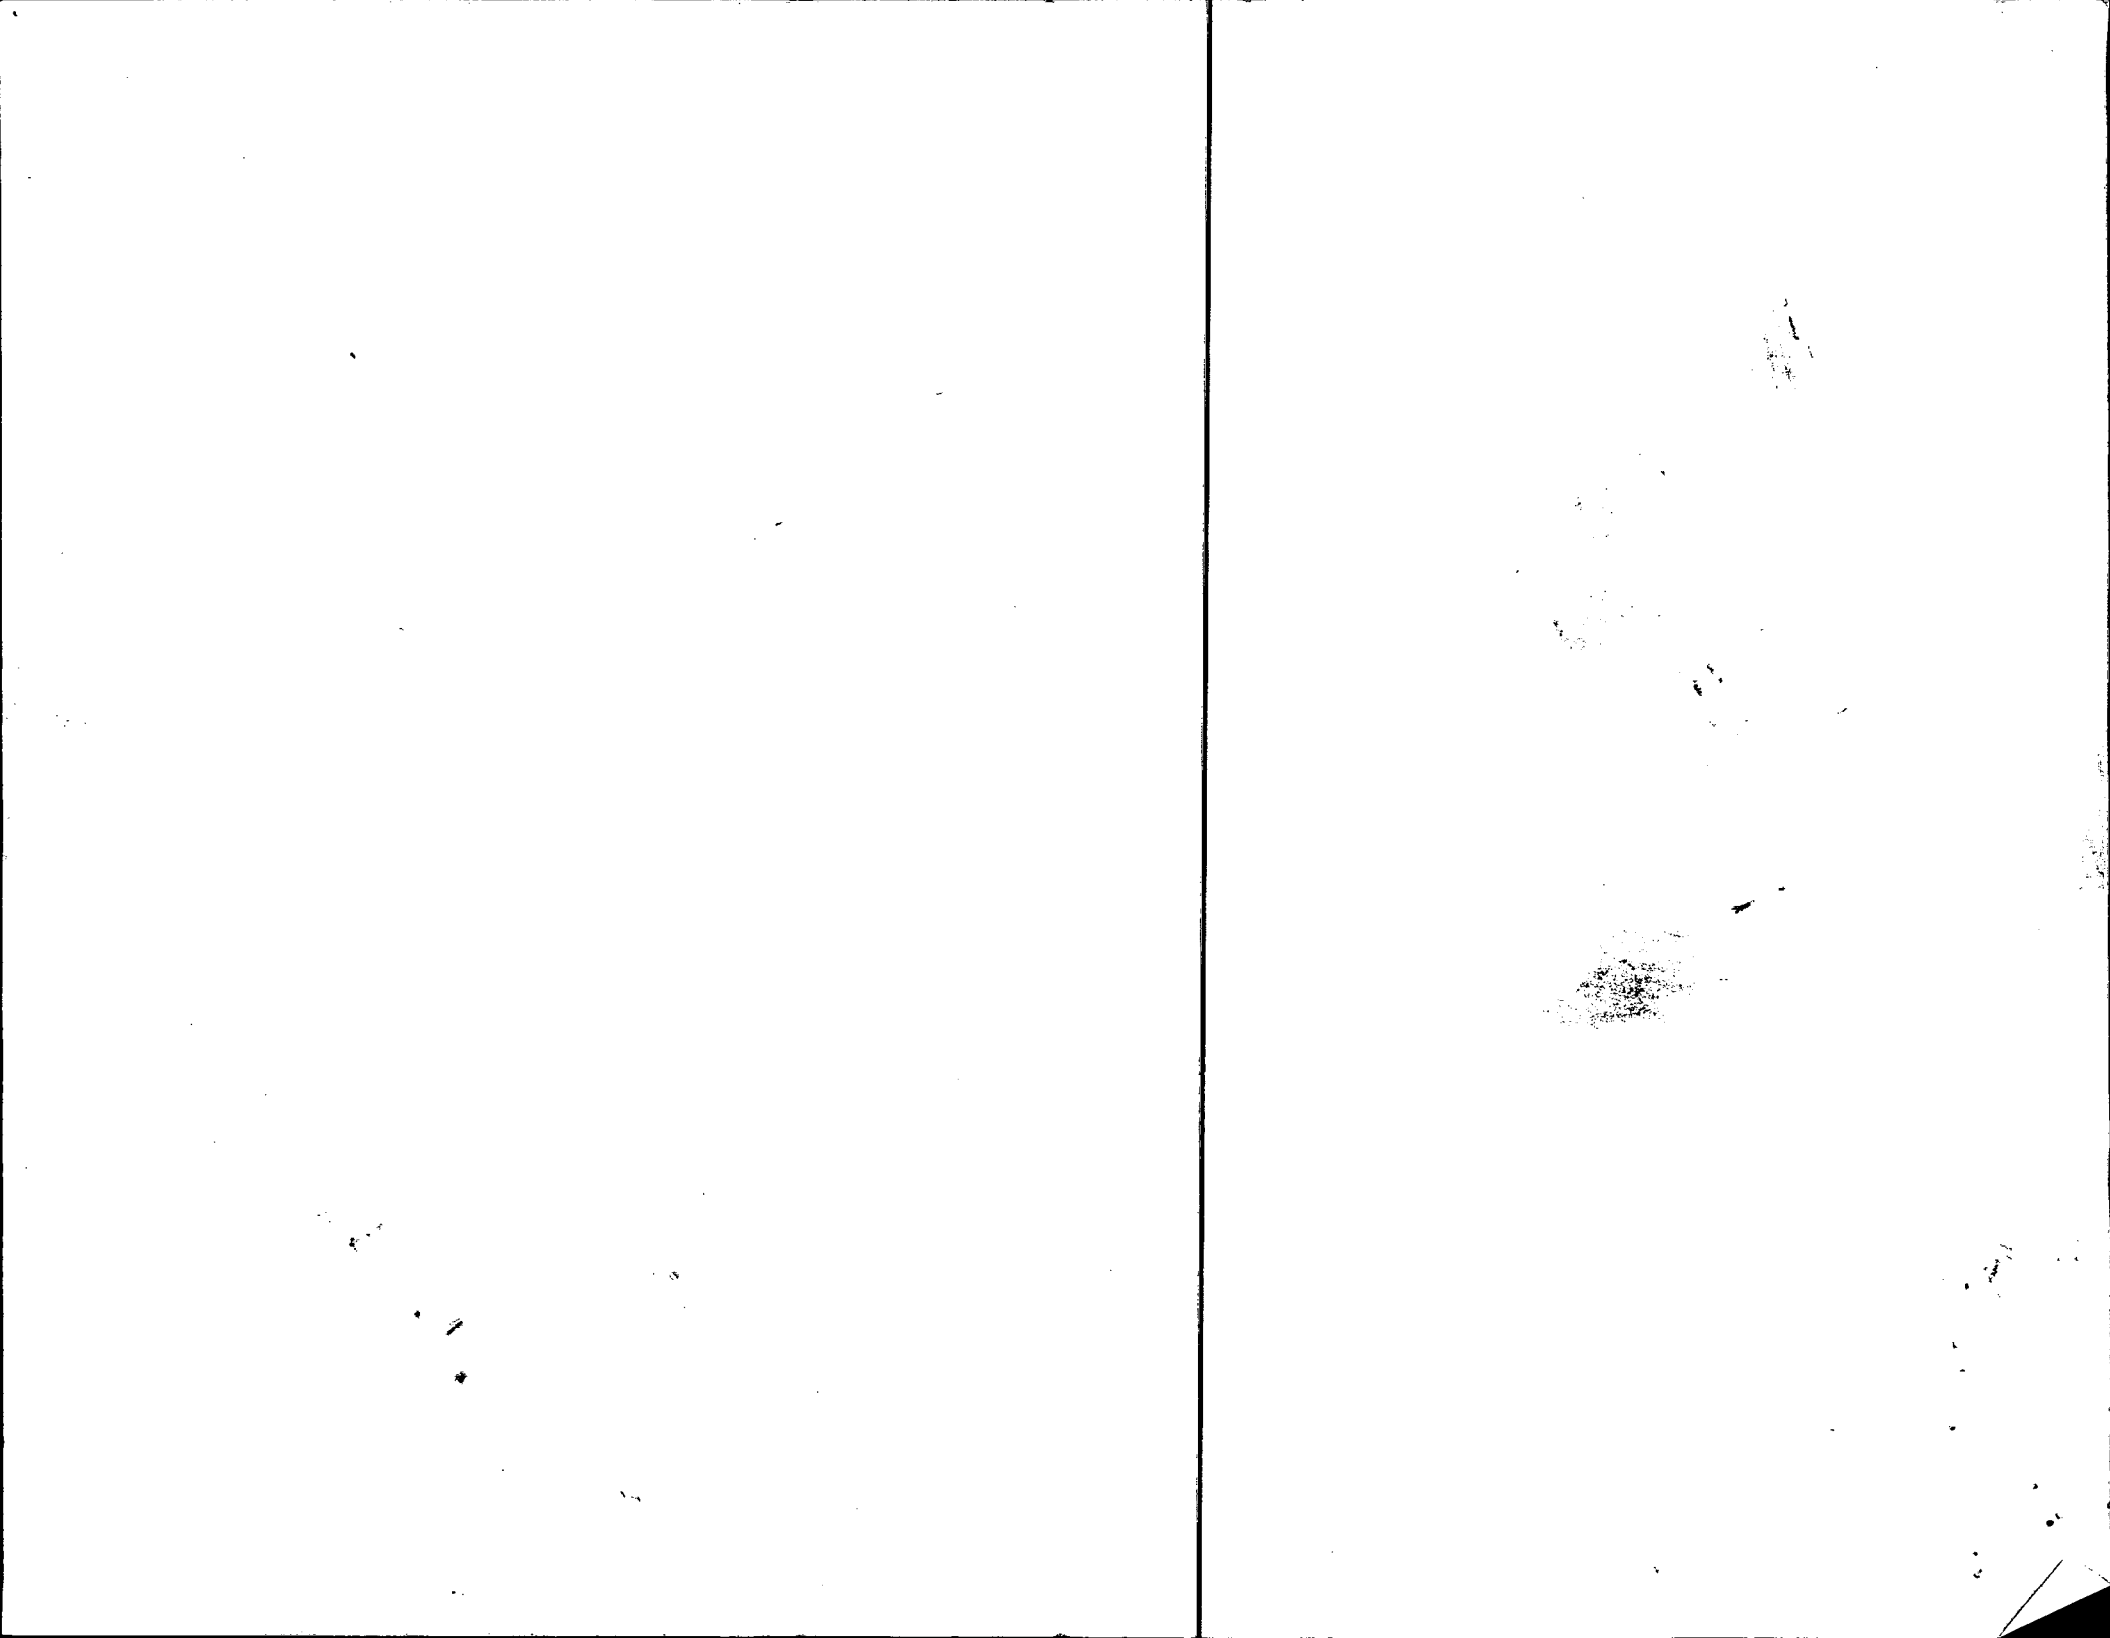

NO. 165

AWS D17.1.2001  
QUALIFICATION TEST RECORD

Name: Berclay Elliot  
Job number: 40696  
Part number: D350 B6 Q1  
Description: 350 skid  
Welding Process: Tig[☒] Mig[ ]  
Base material: Aluminium  
Current: AC[☒] DC[ ]

TEST REQUIREMENTS AND RESULTS

Visual:  
Penetration:

pass[☒] fail[ ]  
pass[☒] fail[ ]

UNACCEPTABLE

Cracks:  
Undercut:  
Pin holes:  
Overlap (cold lap)  
Porosity (surface):  
Coloration:

pass[☒] fail[ ]  
pass[☒] fail[ ]  
Qualifier Del Duval Date of Test Coupon 08-08-01  
Welder Berclay Elliot Date of Test Coupon 08-08-01

The above named individual is qualified in accordance with AWS D17.1.2001 to weld